


取扱注意
この資料は、土地区画整理事業に伴う換地処分時の測量
成果(日本測地系)ですので、あくまで参考資料として
取り扱ってください。

地番区域 神戸市灘区灘北通2丁目 番号 縮尺 1:250 平面直角座標系 第V 作成年月日 平成9年2月日



94	0.342	105
93	0.342	104
92	0.342	103
1	0.342	12

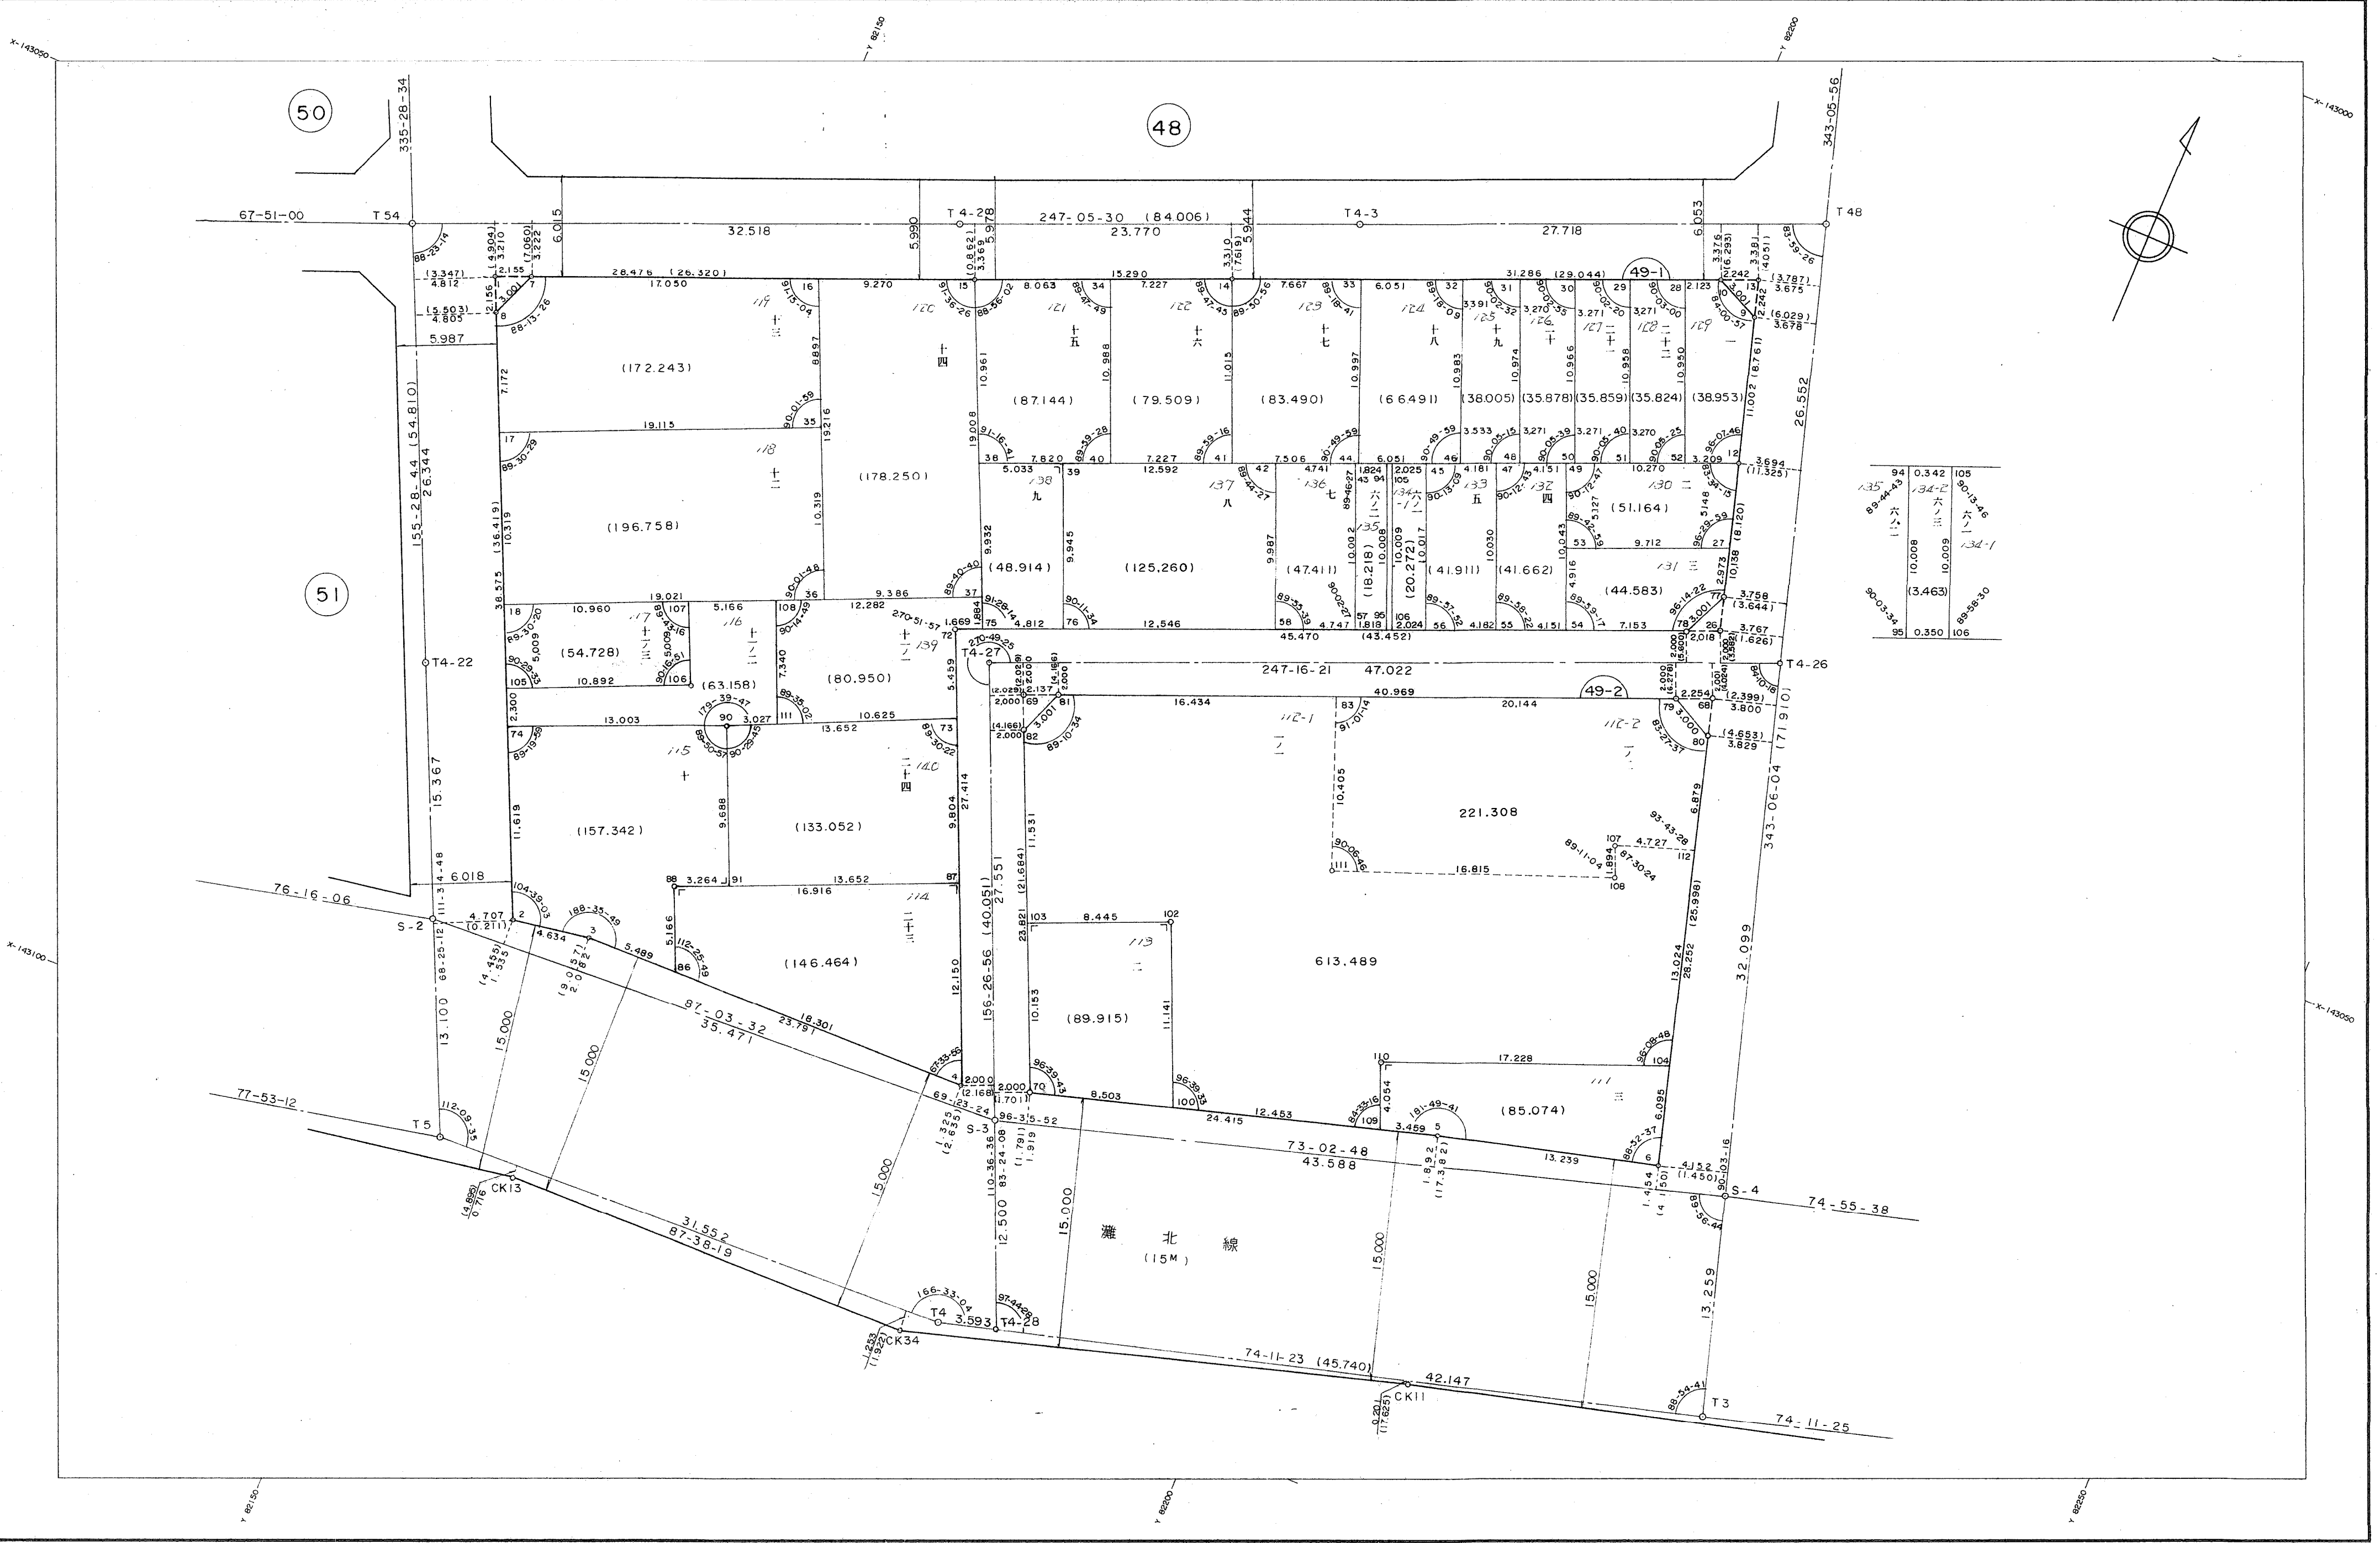