
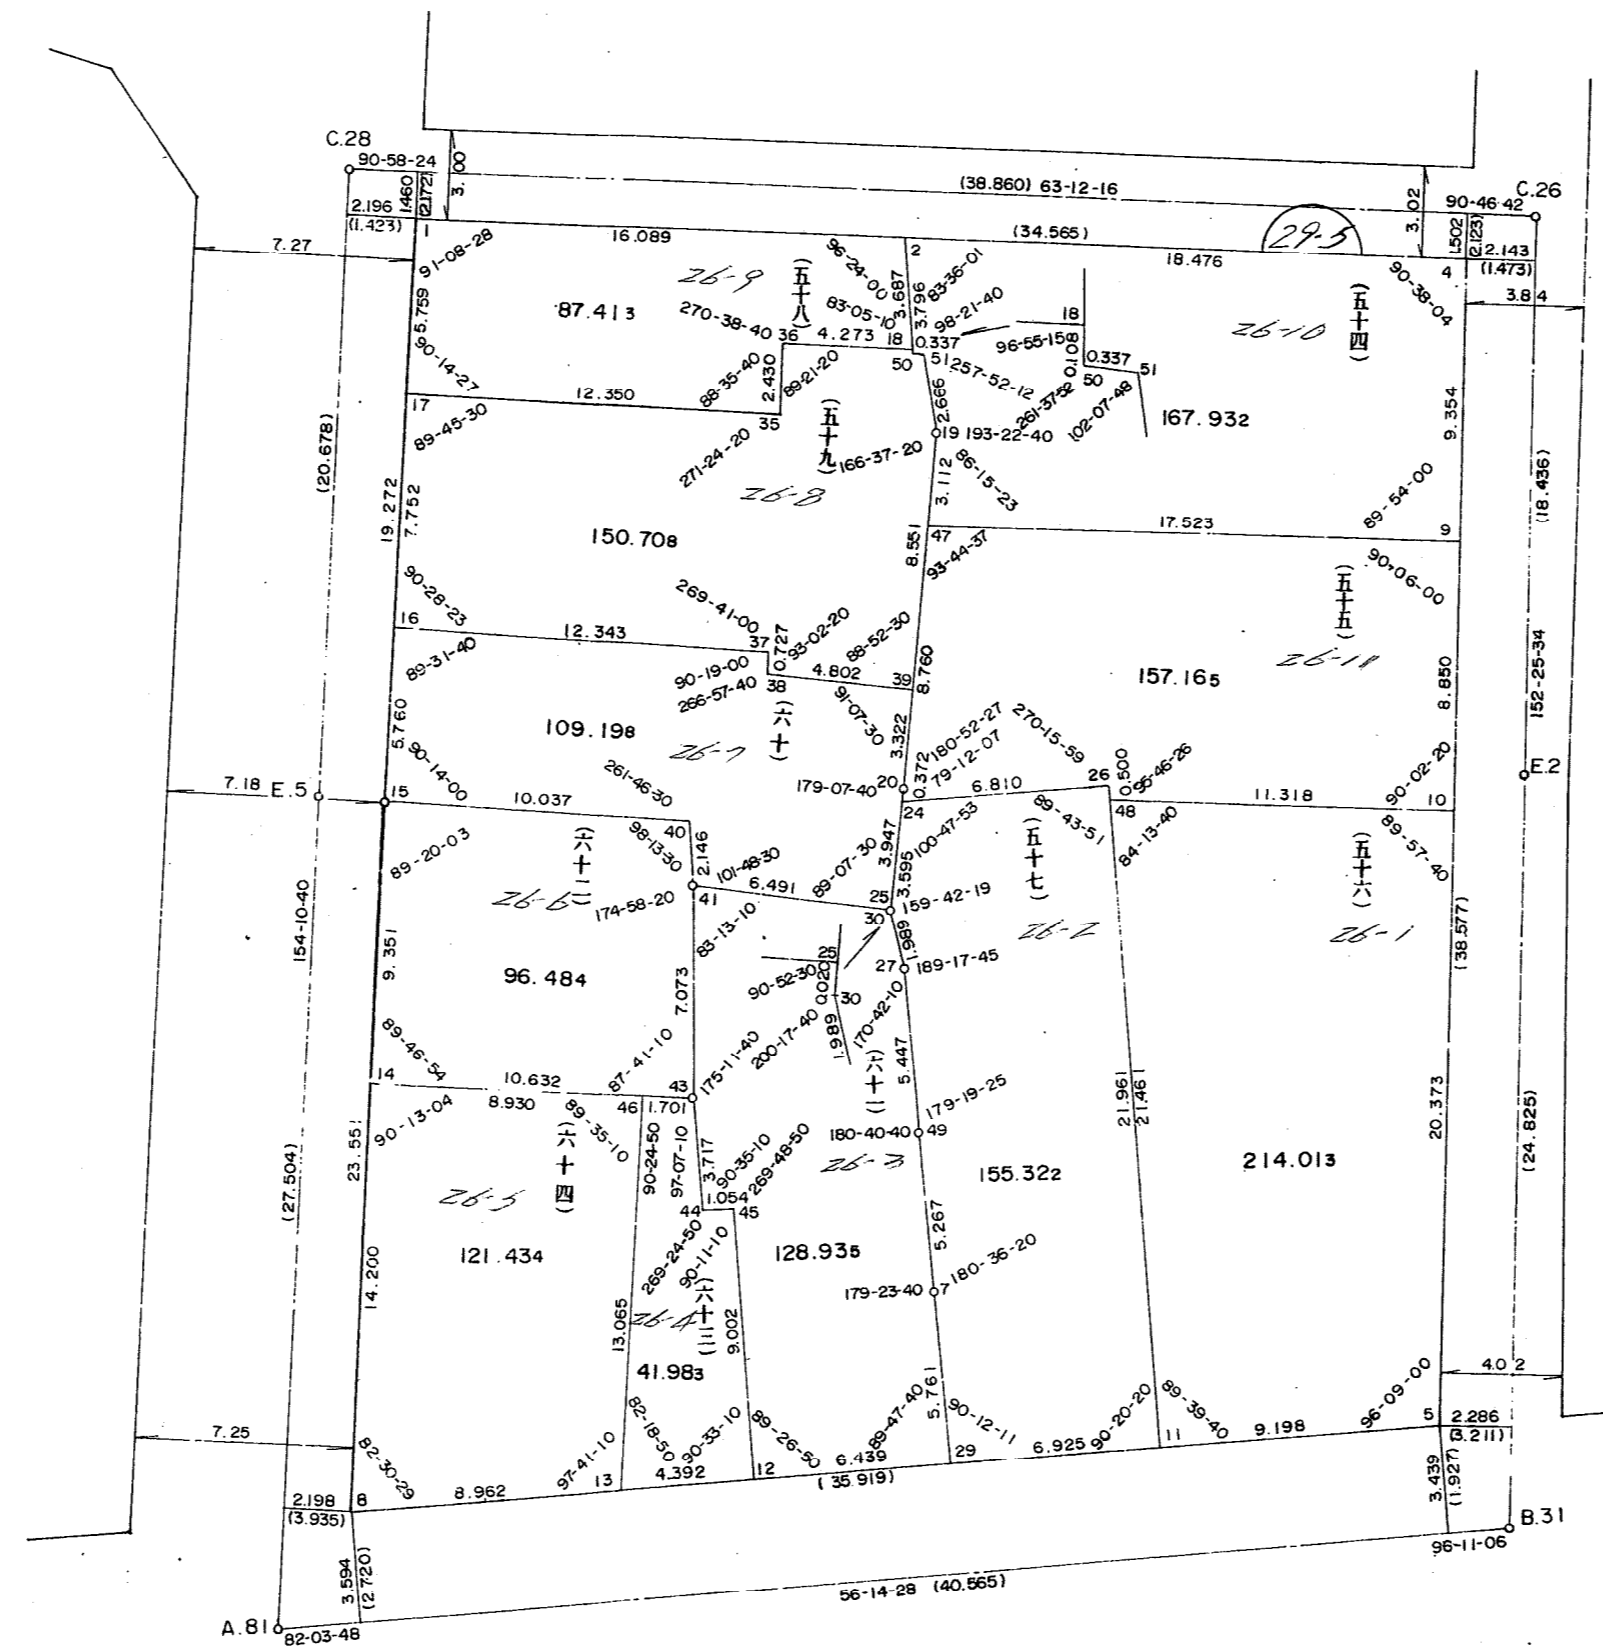


北野換地区29-5街区

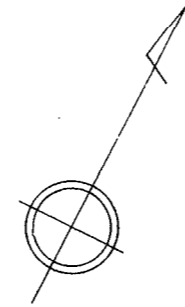

縮尺 $\frac{1}{250}$