


確定測量原図
徳井換地区 37 街区 縮尺 1 : 300

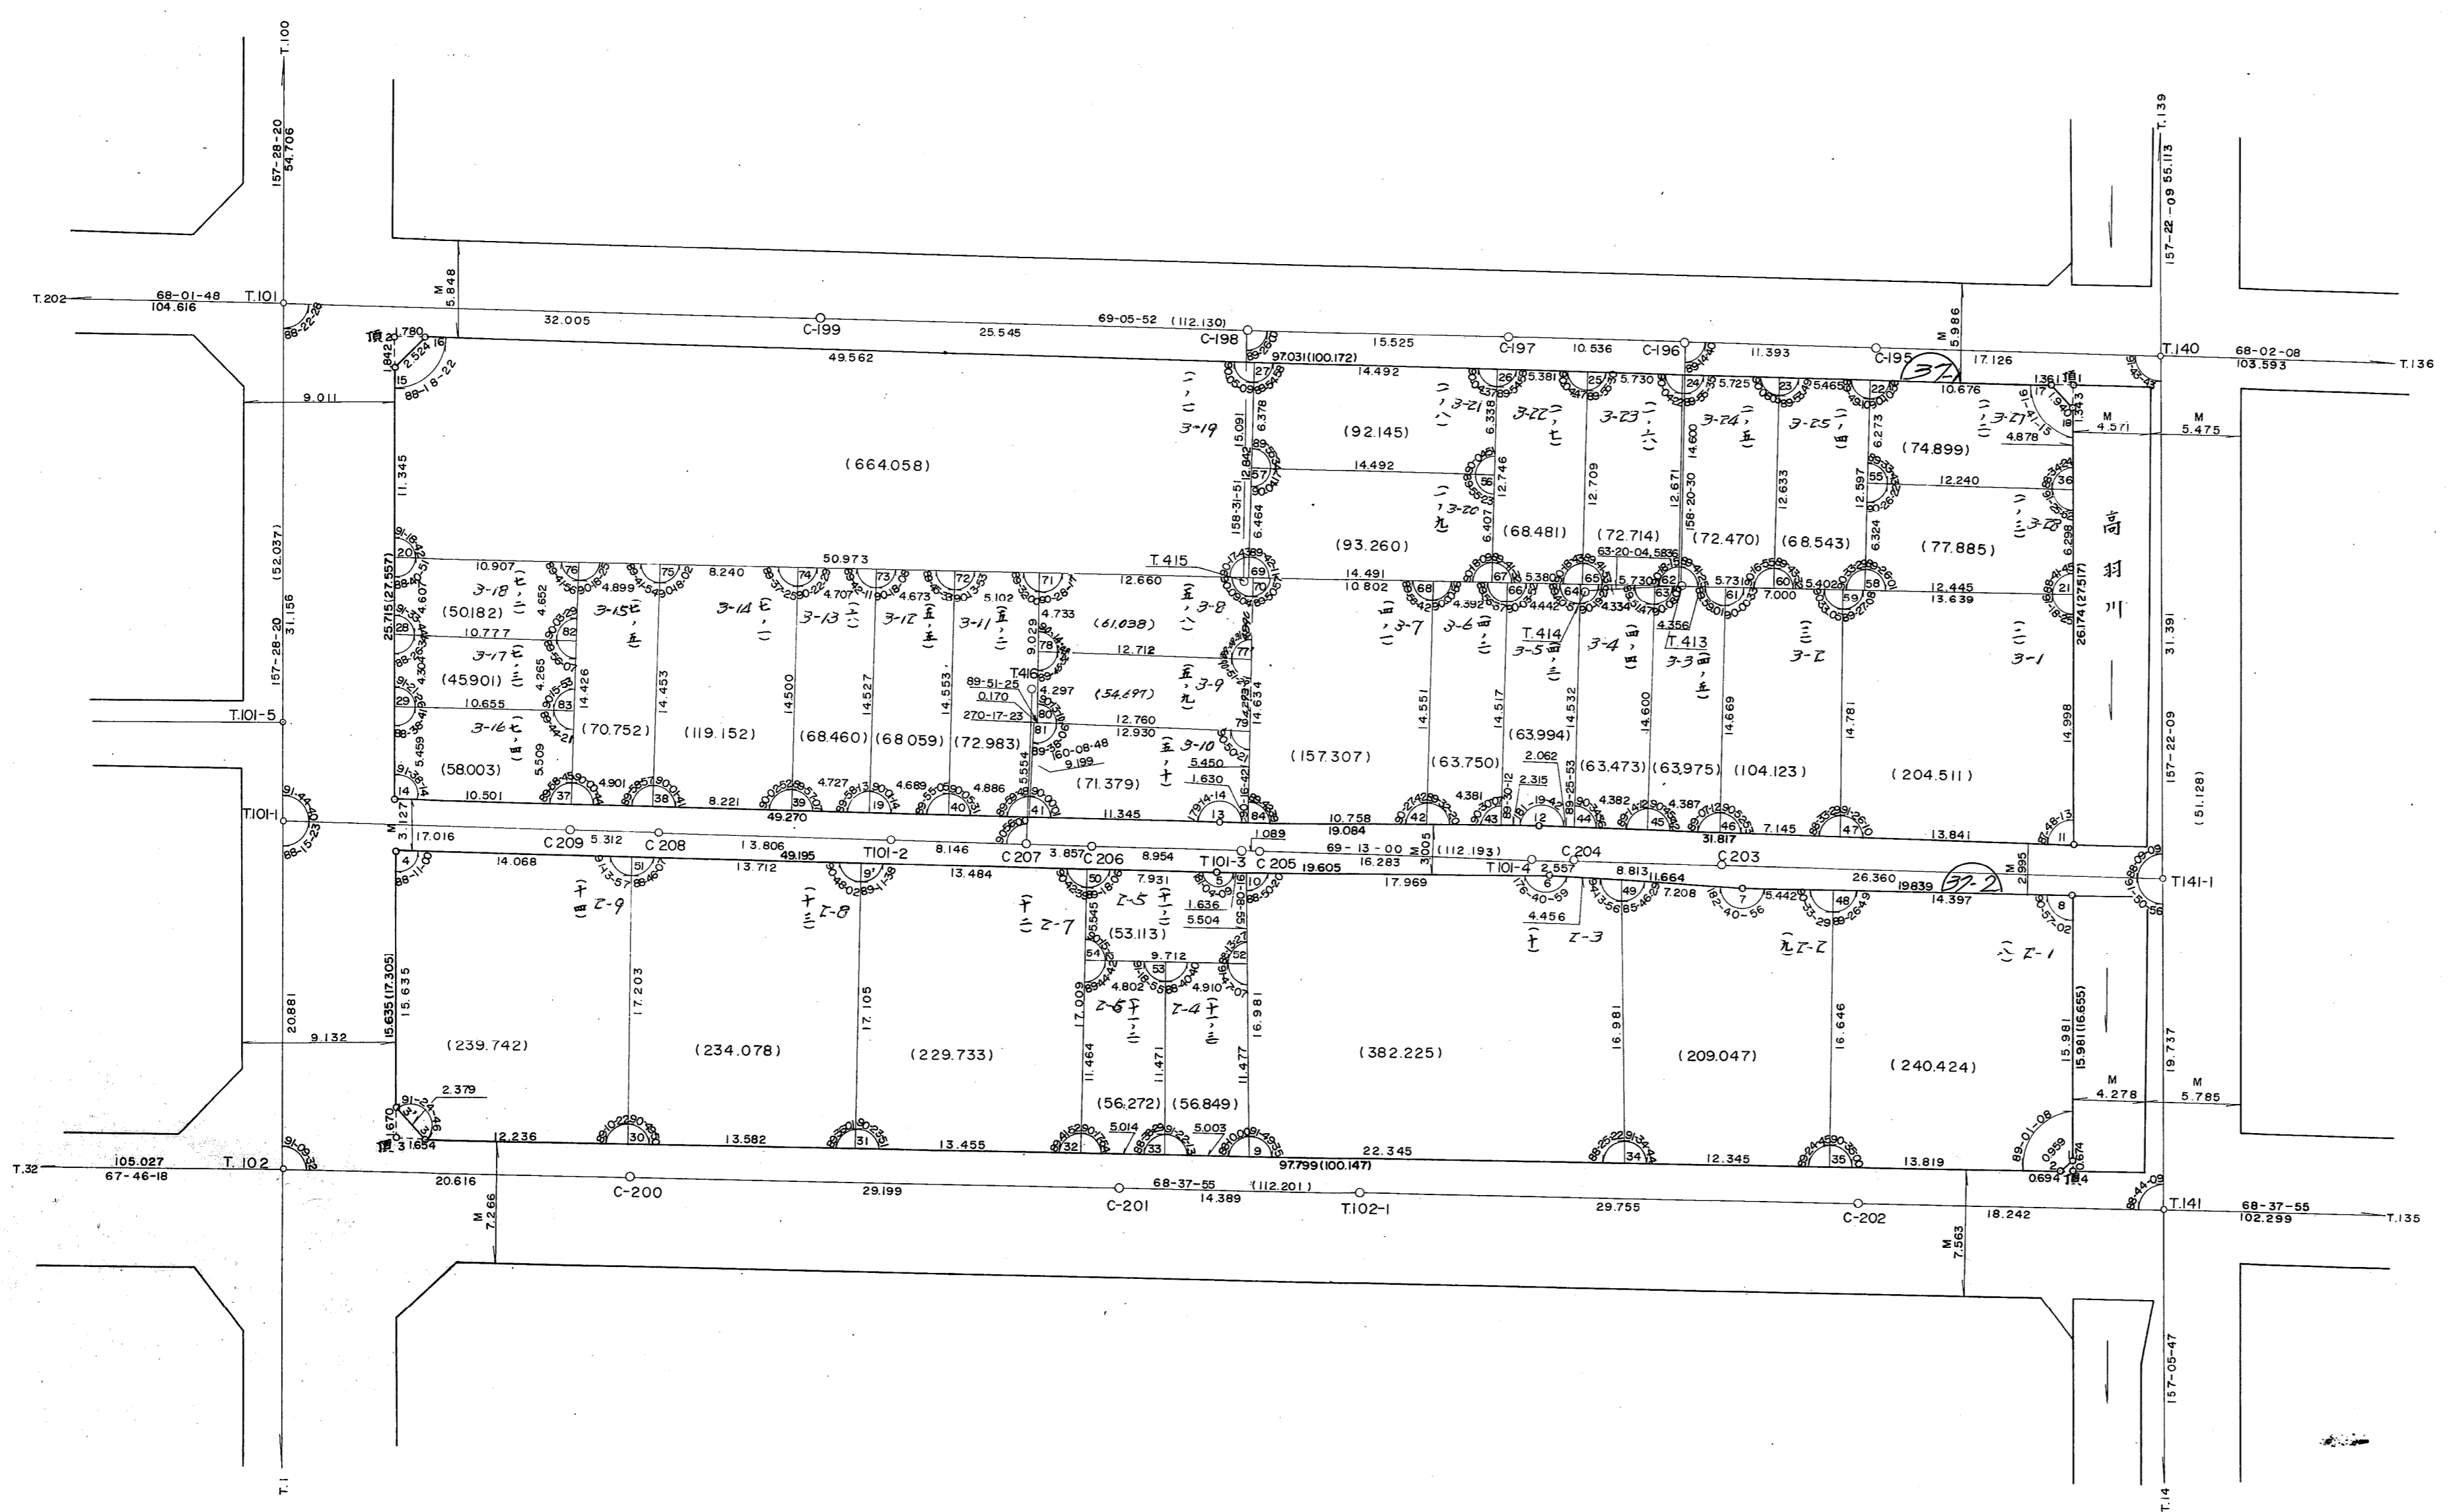

35

