



確定測量原図  
徳井換地区 58 街区 縮尺 1 : 300

阪神国道 28<sup>M</sup>

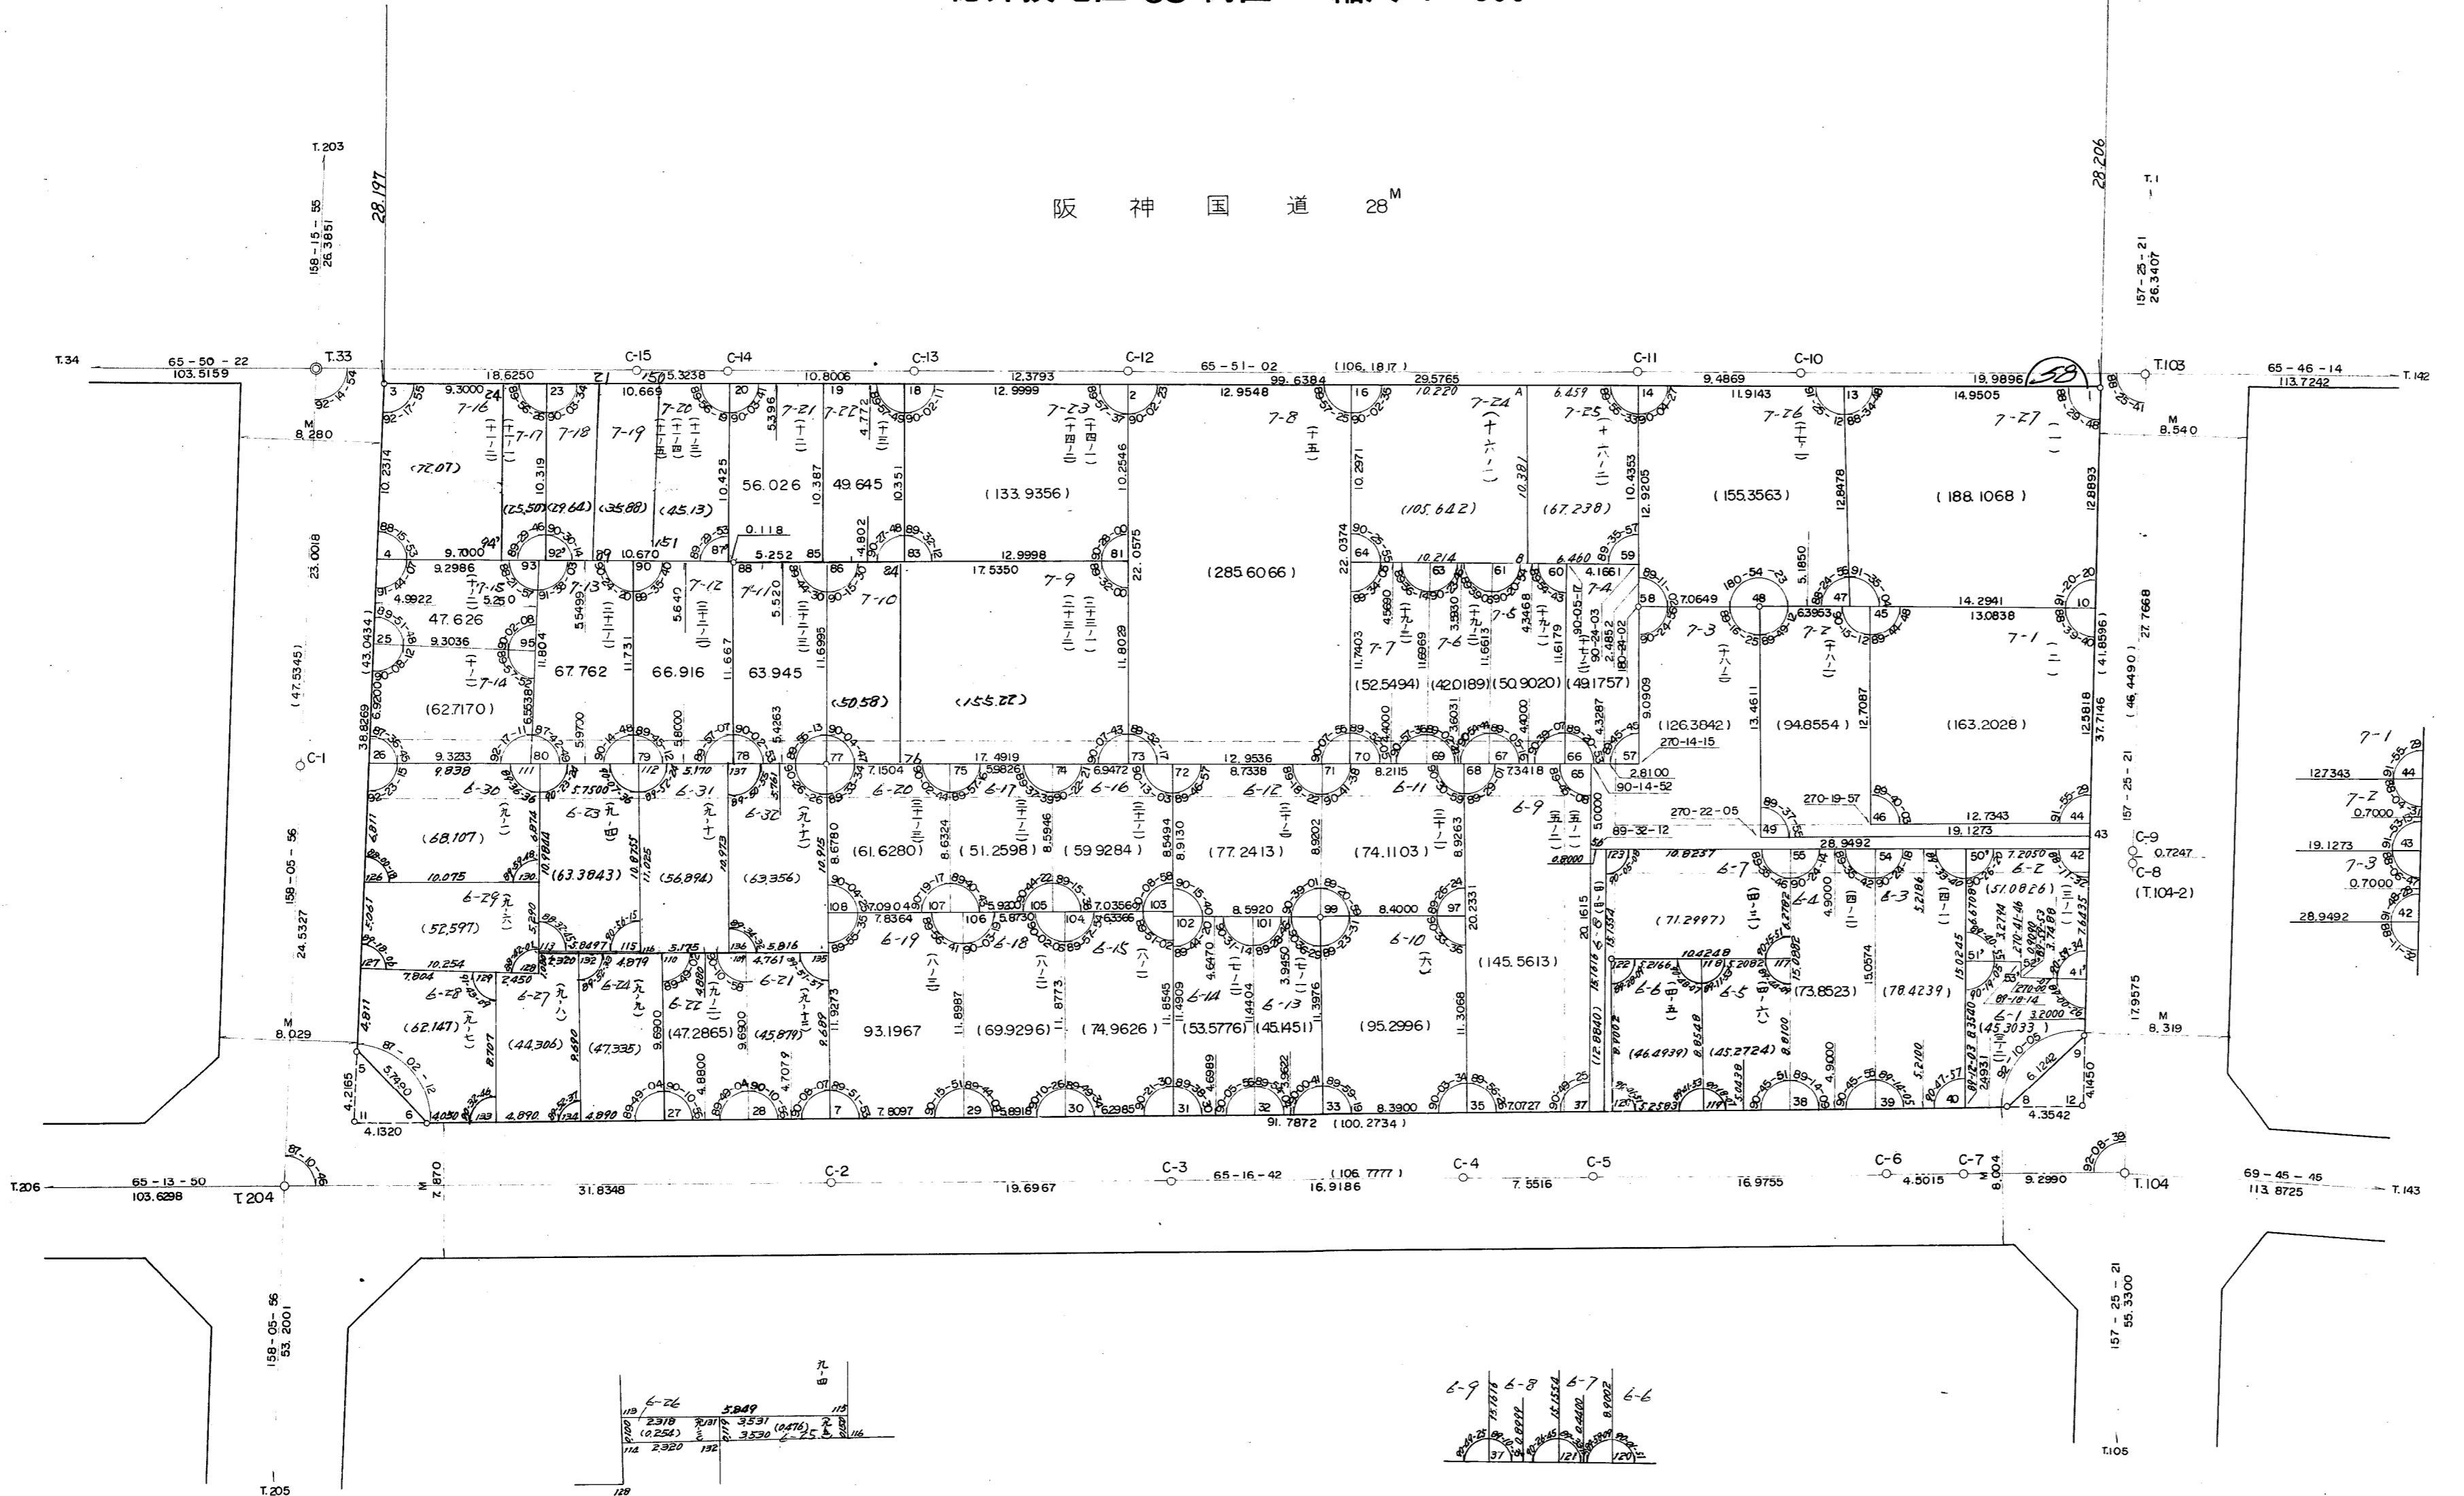

57

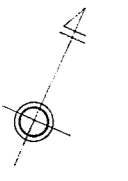

1:83,850

1:83,850

1:83,850

1:83,850