



取扱注意
この資料は、土地区画整理事業に伴う換地処分時の測量
成果（日本測地系）ですので、あくまで参考資料として
取り扱ってください。

確定測量原図

徳井換地区 7 街区

大和町 3 丁目

縮尺 1 : 300

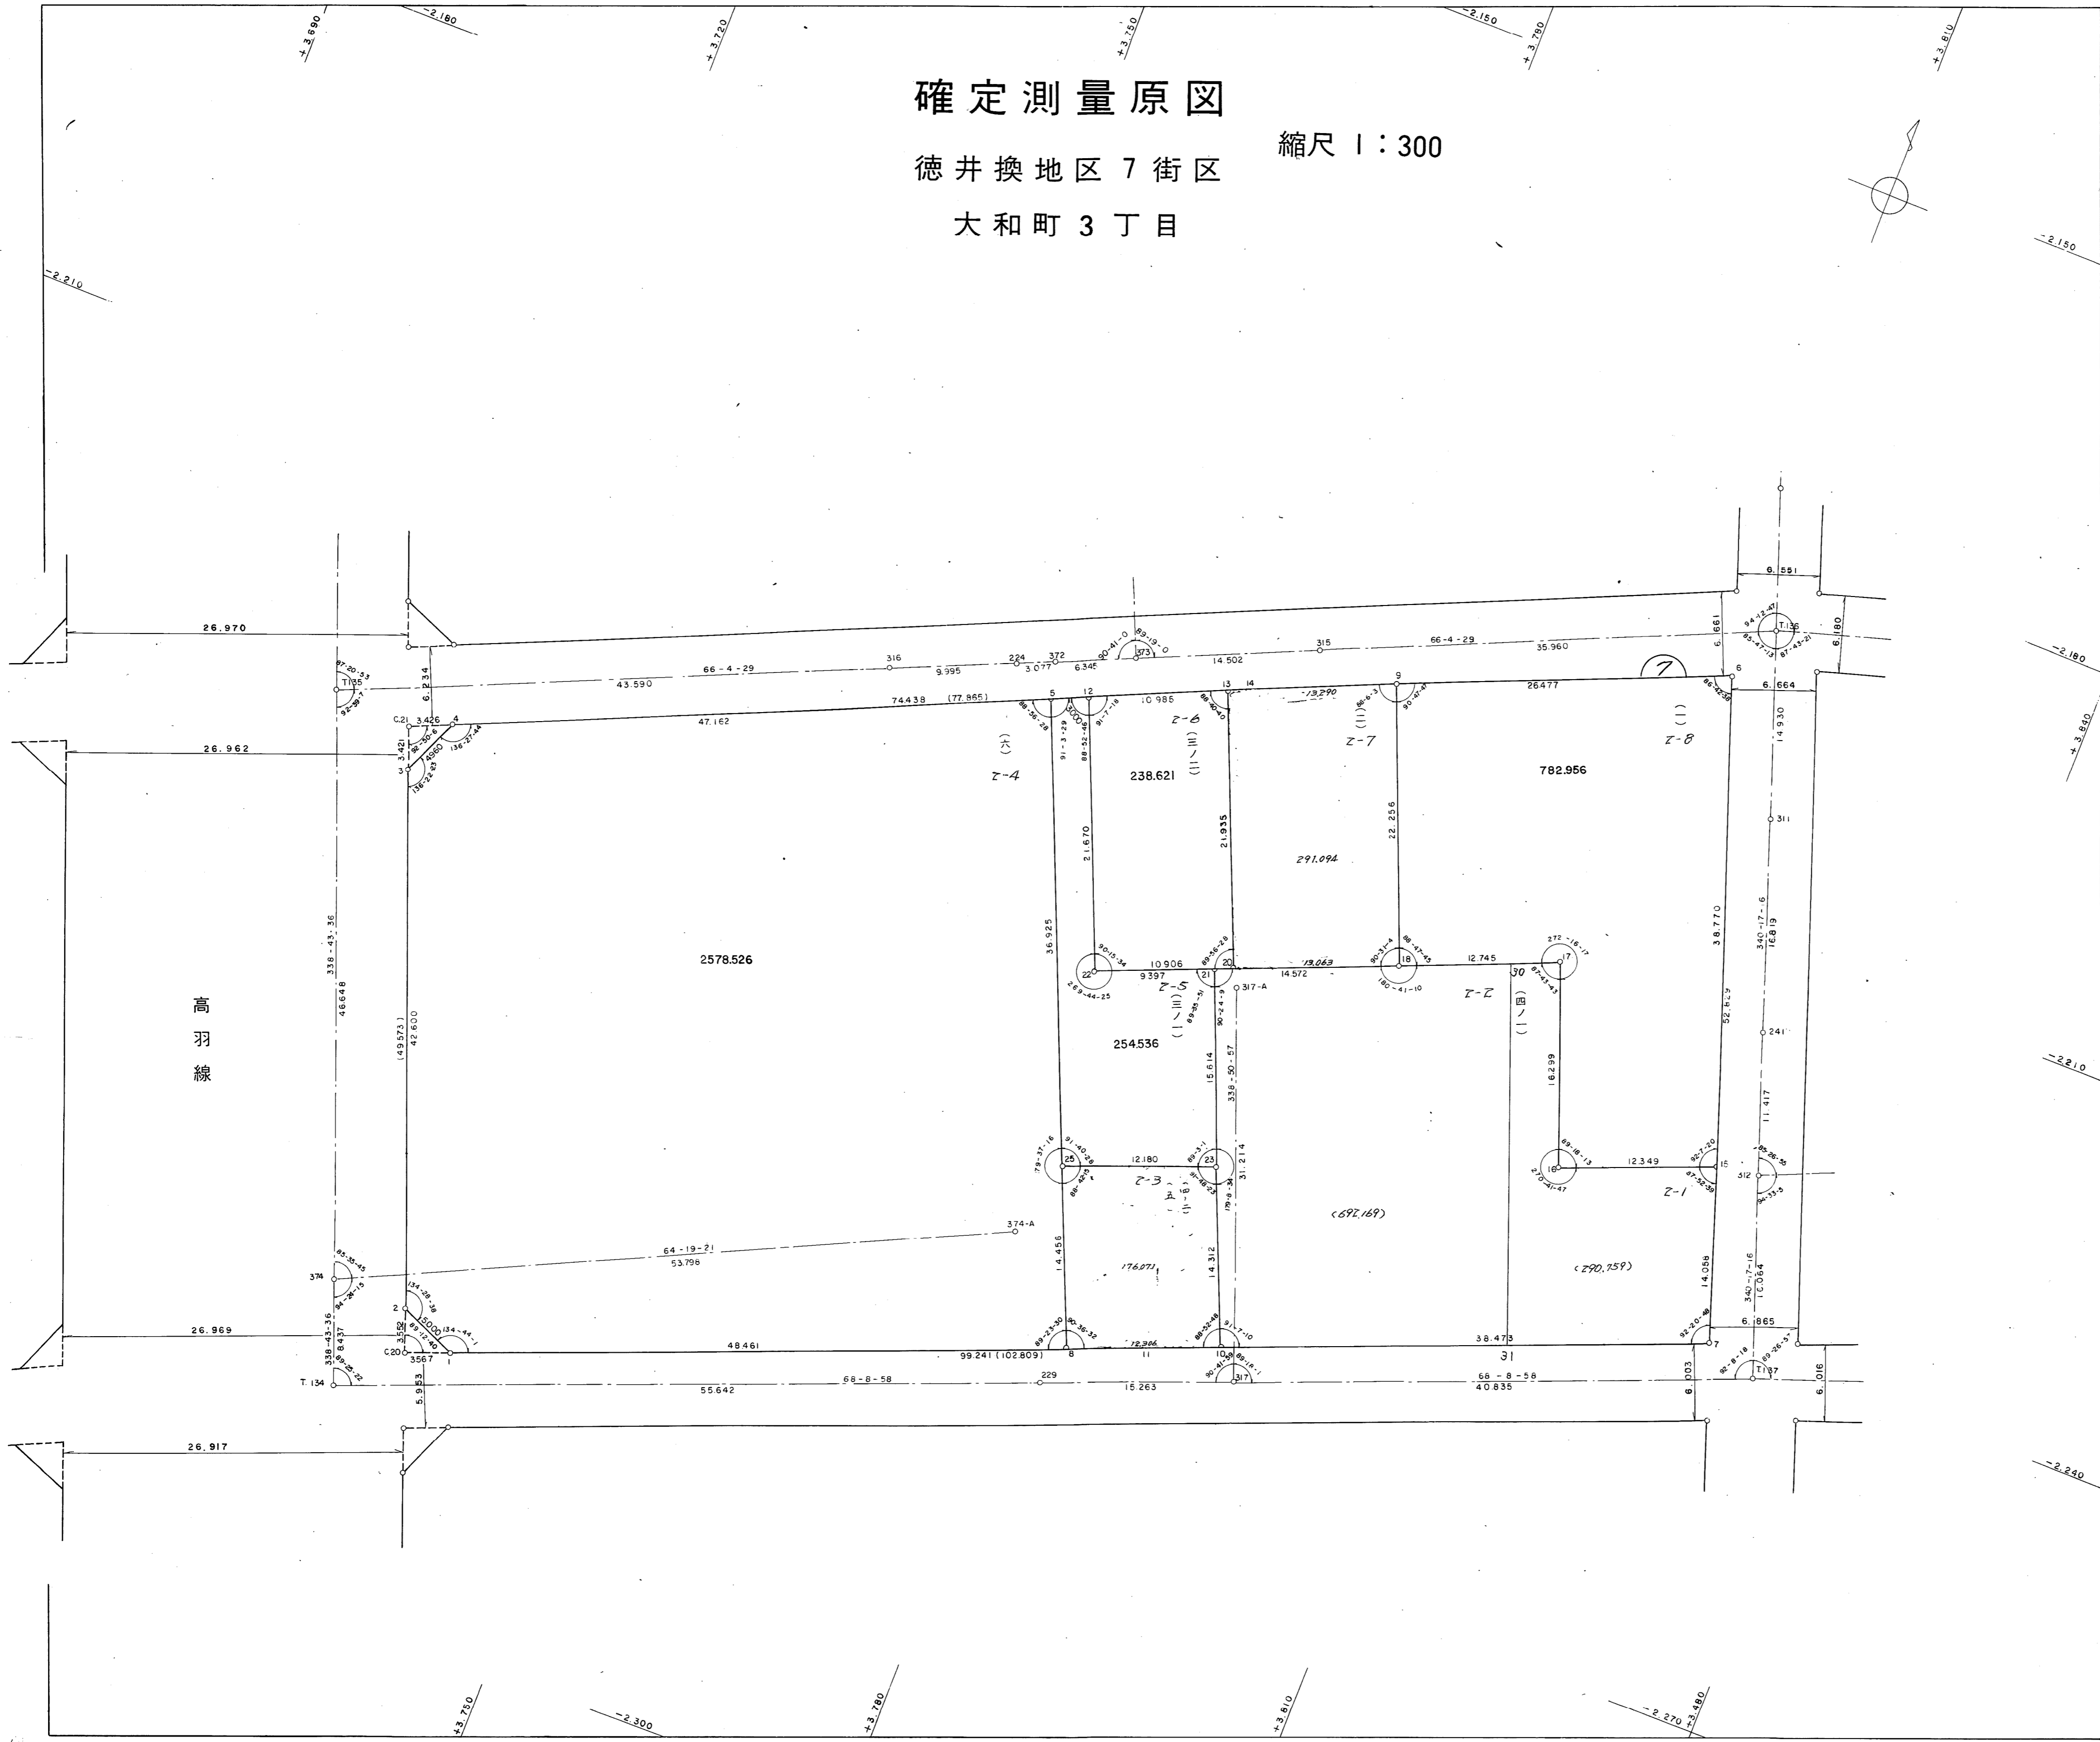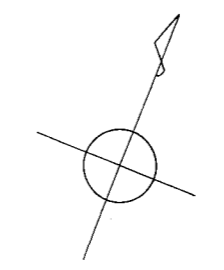

高羽線

26.970

26.962

26.969

26.917

2578.526

43.590

66-4-29

47.162

74.438

77.851

10.906

9.397

12.180

17.697

14.455

64-19-71

53.786

49.461

55.642

99.241 (102.809)

15.263

68-8-58

15.263

68-8-58

40.835

6.016

6.016

