

葺合地区琴緒換地区 10B 街区 確定測量原図


地番区域 神戸市中央区旭通2丁目

番号 36 縮尺 1:250

平面直角座標系 第 V

作成年月日 平成8年9月日

取扱注意
 この資料は、土地画整理事業に伴う換地処分時の測量
 成果（日本測地系）ですので、あくまで参考資料として
 取り扱ってください。

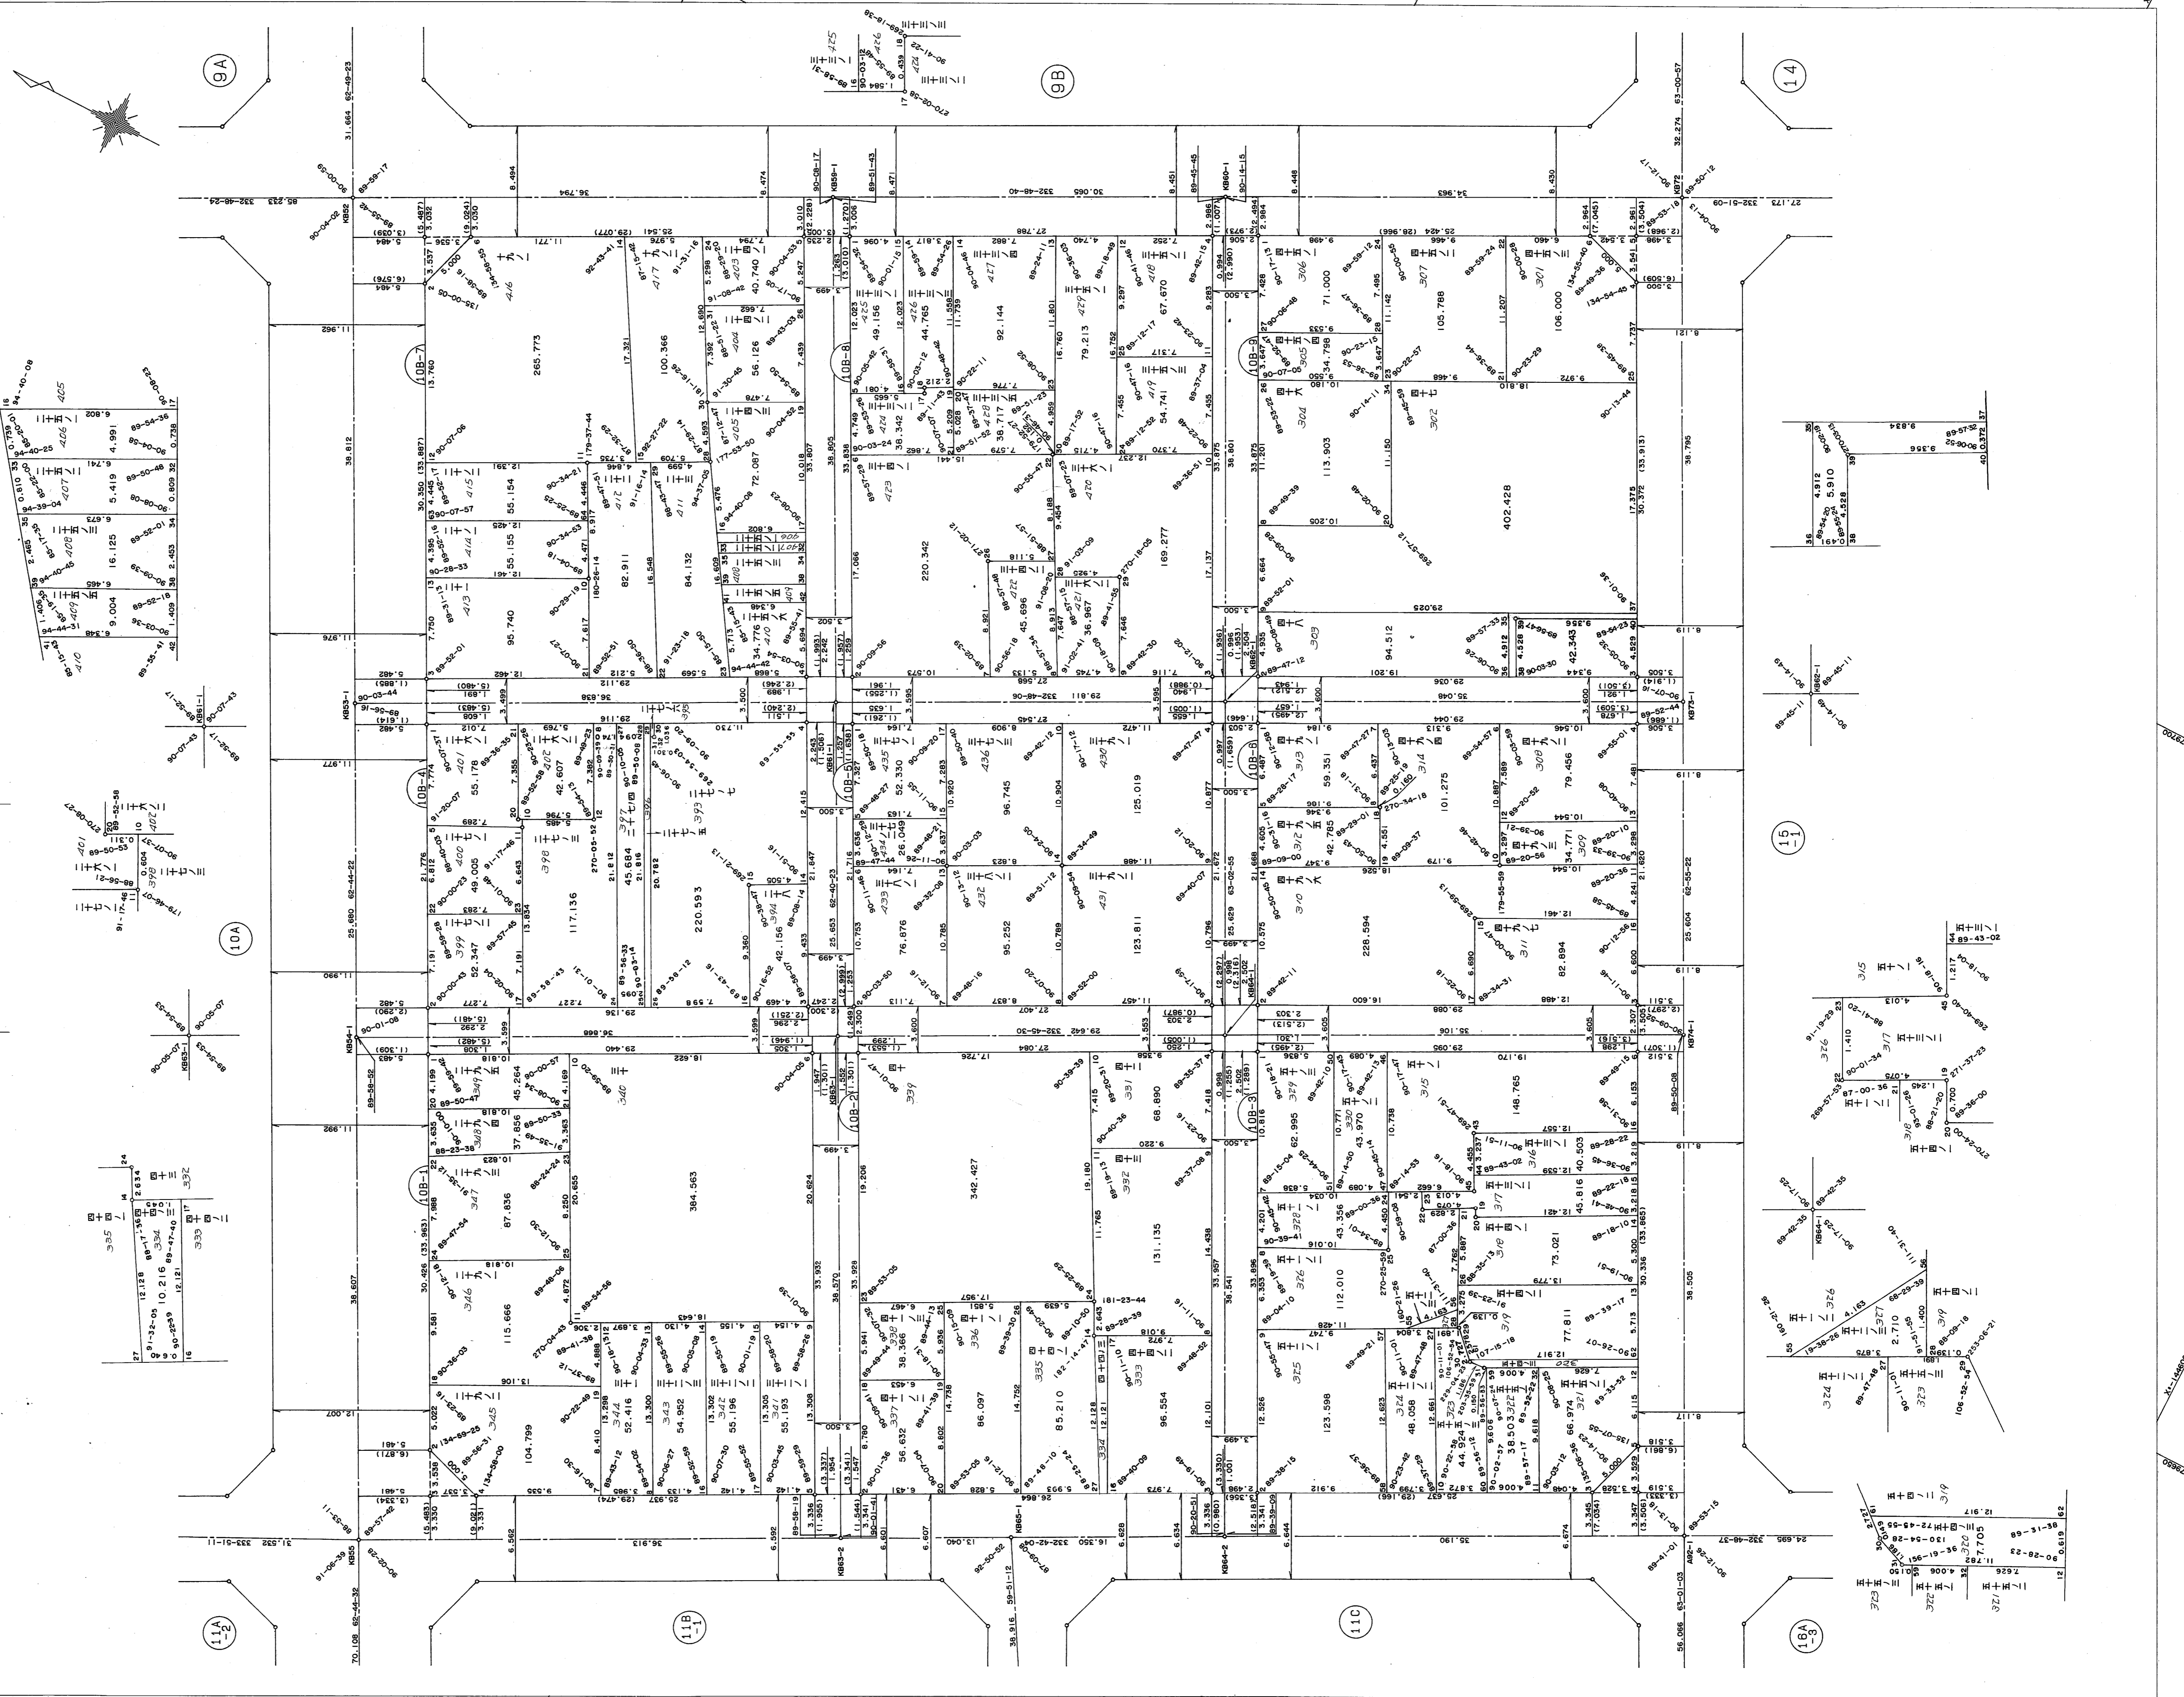

25	90-03-25	21.816	397


